


~~1:214 sq ft~~
~~1:226 sq ft~~
 23,604
 34,389
 Unit 2

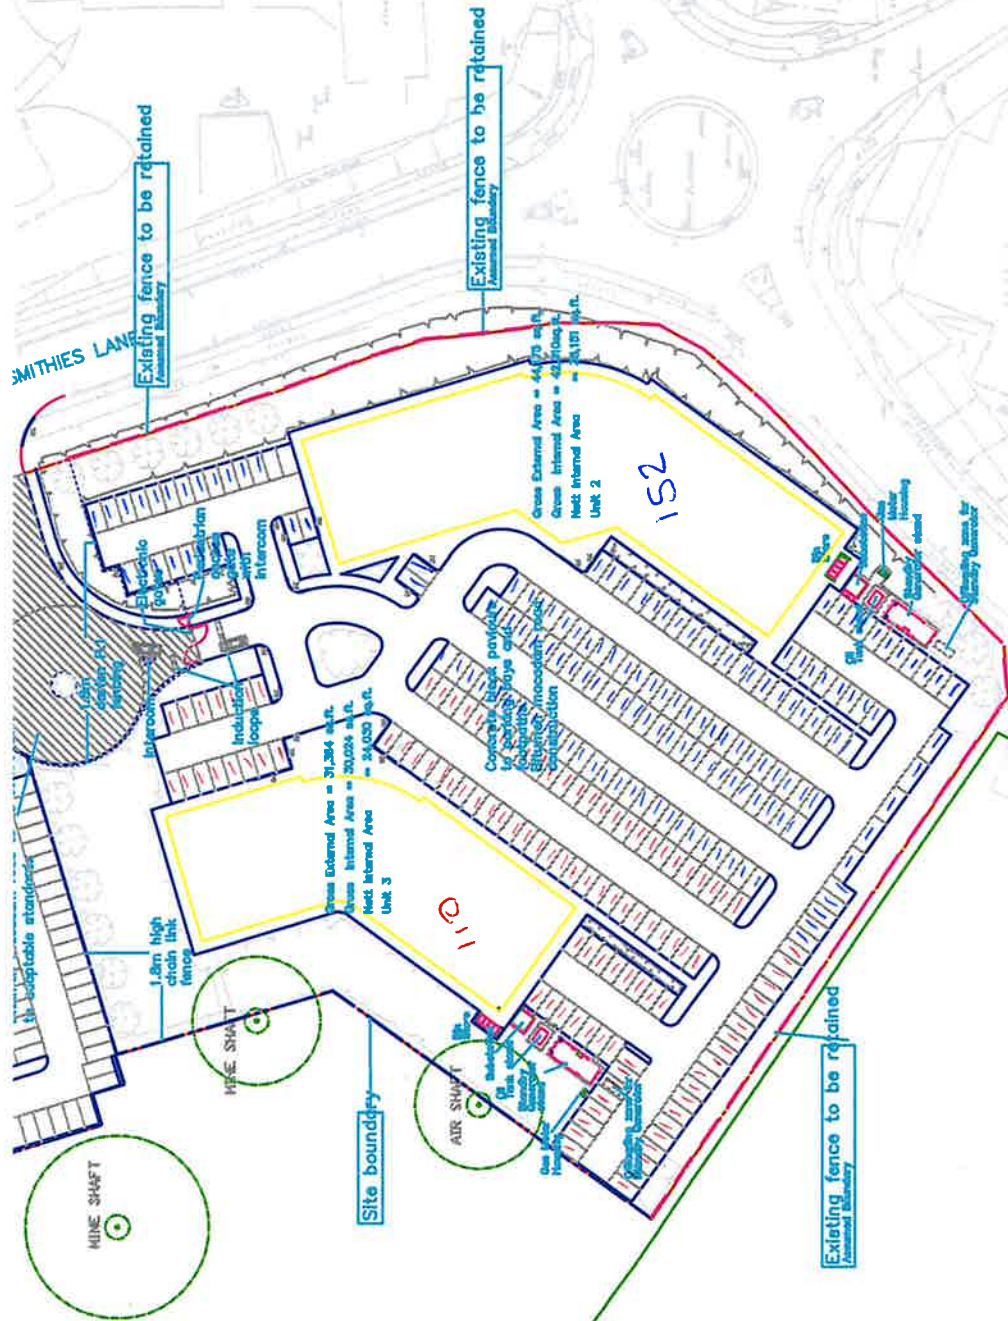

- F** 17/12/18 U.S. AS BUILT
 - E** 03/12/19 U.S. ACCESS GATES INSTALLED, BUT REDUCED LOOP SYSTEM ADDED
 - D** 23/11/19 U.S. SWAPPED ROAD ADDRESSES TO ACCESS ROAD. EXTERNAL FENCES & ACCESS GATES ADDED
 - C** 19/01/20 U.S. BOUNDARY LINE UPDATED PER OF UNIT 2 - AND BATTER HOLDING LINE. EXISTING UNIT 2 & 3 LANDSCAPING AND ACCESS GATES ADDED
 - B** 24/02/20 U.S. HARDSCAPE BATTERS & CONCRETE RETAINMENT CUT/UPDATED
 - A** 02/02/20 U.S. RETAINMENT WALLS & CONCRETE ROAD CONSTRUCTION ADDED. TOTAL AREA CALCULATIONS PROVIDED. UNIT 2 FOOTPRINT & GATE POSITION TO SOUTH BOUNDARY ADDED
- AS BUILT**
- CANNOCK INVESTMENTS
CALLIFLEX BUSINESS PARK
DEANNE VALLEY**
- PROPOSED SITE PLAN**
- 200 2006/02
1:500 MP

Ryder

0121 234 100
 0121 234 100
 0121 234 100
 0121 234 100