


Notes

1. The architect retains copyright of this drawing. It should not be reproduced without prior written consent
2. Do not scale from this drawing, unless for PLANNING Project stage. Errors/omissions should be reported to the architect.
- 3.

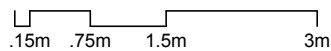

NB: All dimensions shown are approximate as built for information only.

BUILDING CONTROL

Date of issue \ Project stage

17.07.17

Revisions

- | | |
|------------|---------------------------------------|
| A 27.06.17 | Stairs to commercial revised |
| B 05.07.17 | Stairs revised
Bin storage revised |
| C 17.07.17 | As built dimensions |

David Money Architects

21 Claylands Place London SW8 1NL
T/F: 020 7587 3584 E: studio@davidmoney.com


Job title

3 Richborne Terrace, SW8 1AS
Lambeth

Drawing title

Basement plan
Setting out

Job number	Scale@A3	Drawing number
DM242	1:75	4.12.01C

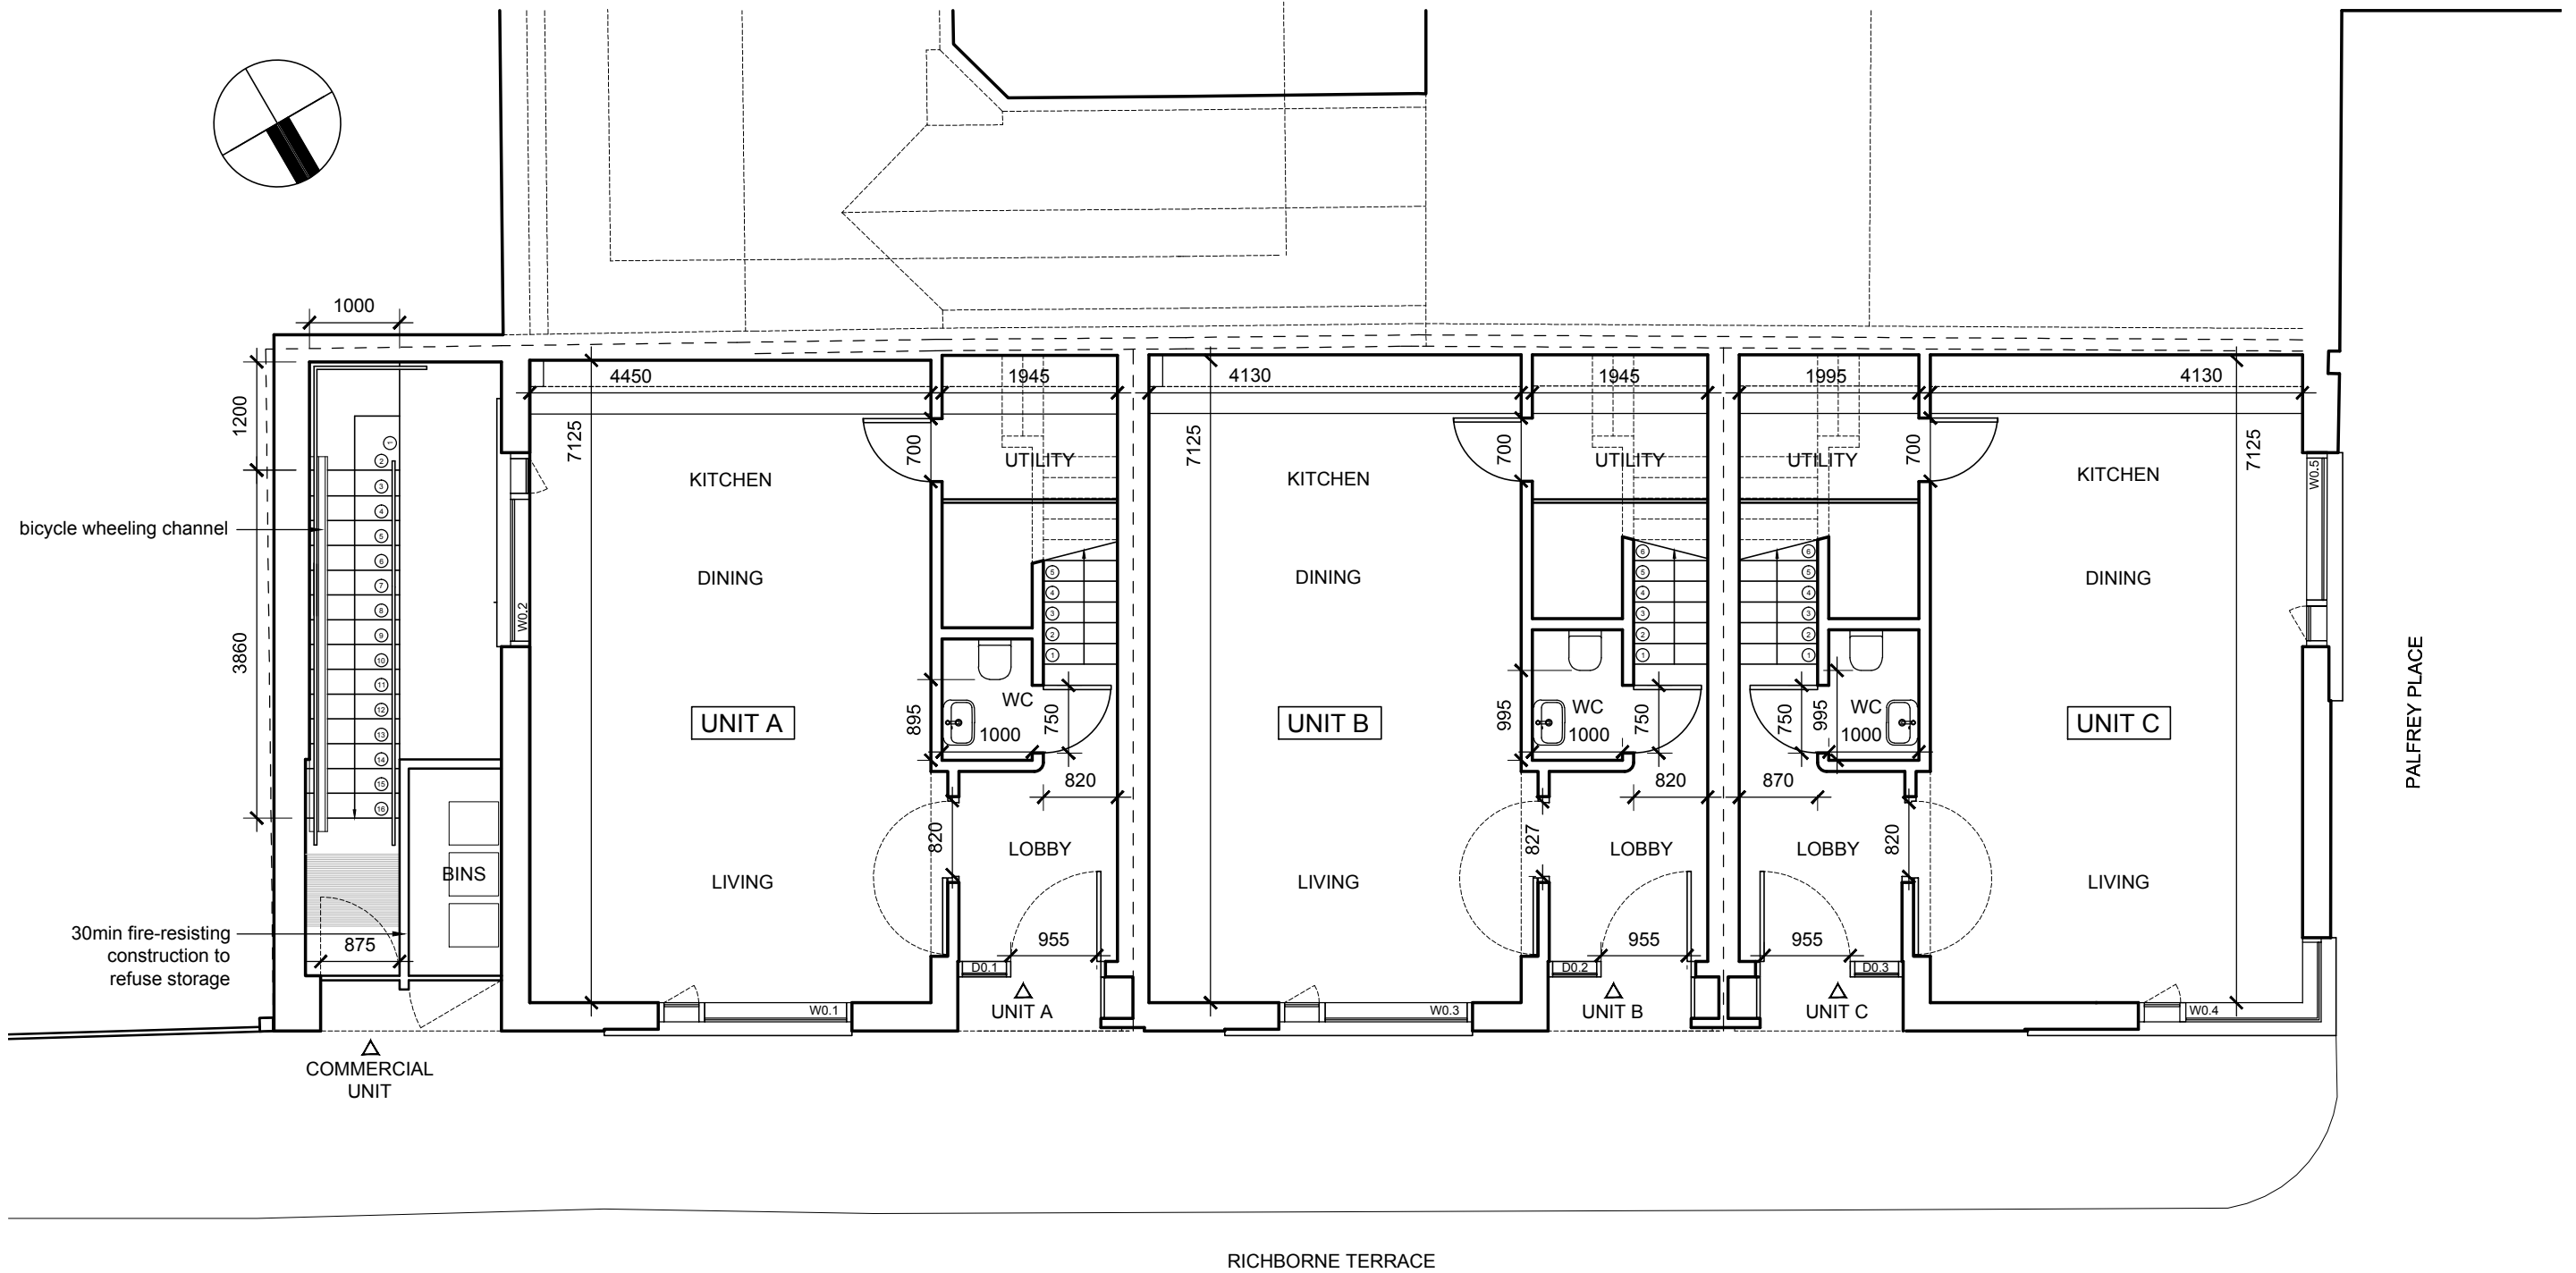

Notes

1. The architect retains copyright of this drawing. It should not be reproduced without prior written consent
2. Do not scale from this drawing, unless for PLANNING Project stage. Errors/omissions should be reported to the architect.
- 3.

NB: All dimensions shown are approximate as built for information only.

BUILDING CONTROL

Date of issue \ Project stage

17.07.17

Revisions

- | | |
|------------|--|
| A 27.06.17 | Stairs and entrance to commercial revised
Bin storage revised |
| A 29.06.17 | Fire strategy notes added
WCs revised |
| 07.05.17 | Stairs revised
Bin storage revised |
| D 17.07.17 | As built dimensions |

David Money Architects

21 Claylands Place London SW8 1NL
T/F: 020 7587 3584 E: studio@davidmoney.com

Job title


3 Richborne Terrace, SW8 1AS
Lambeth

Drawing title

Ground floor plan
Setting out

Job number Scale@A3 Drawing number

DM242 1:75 4.12.02D

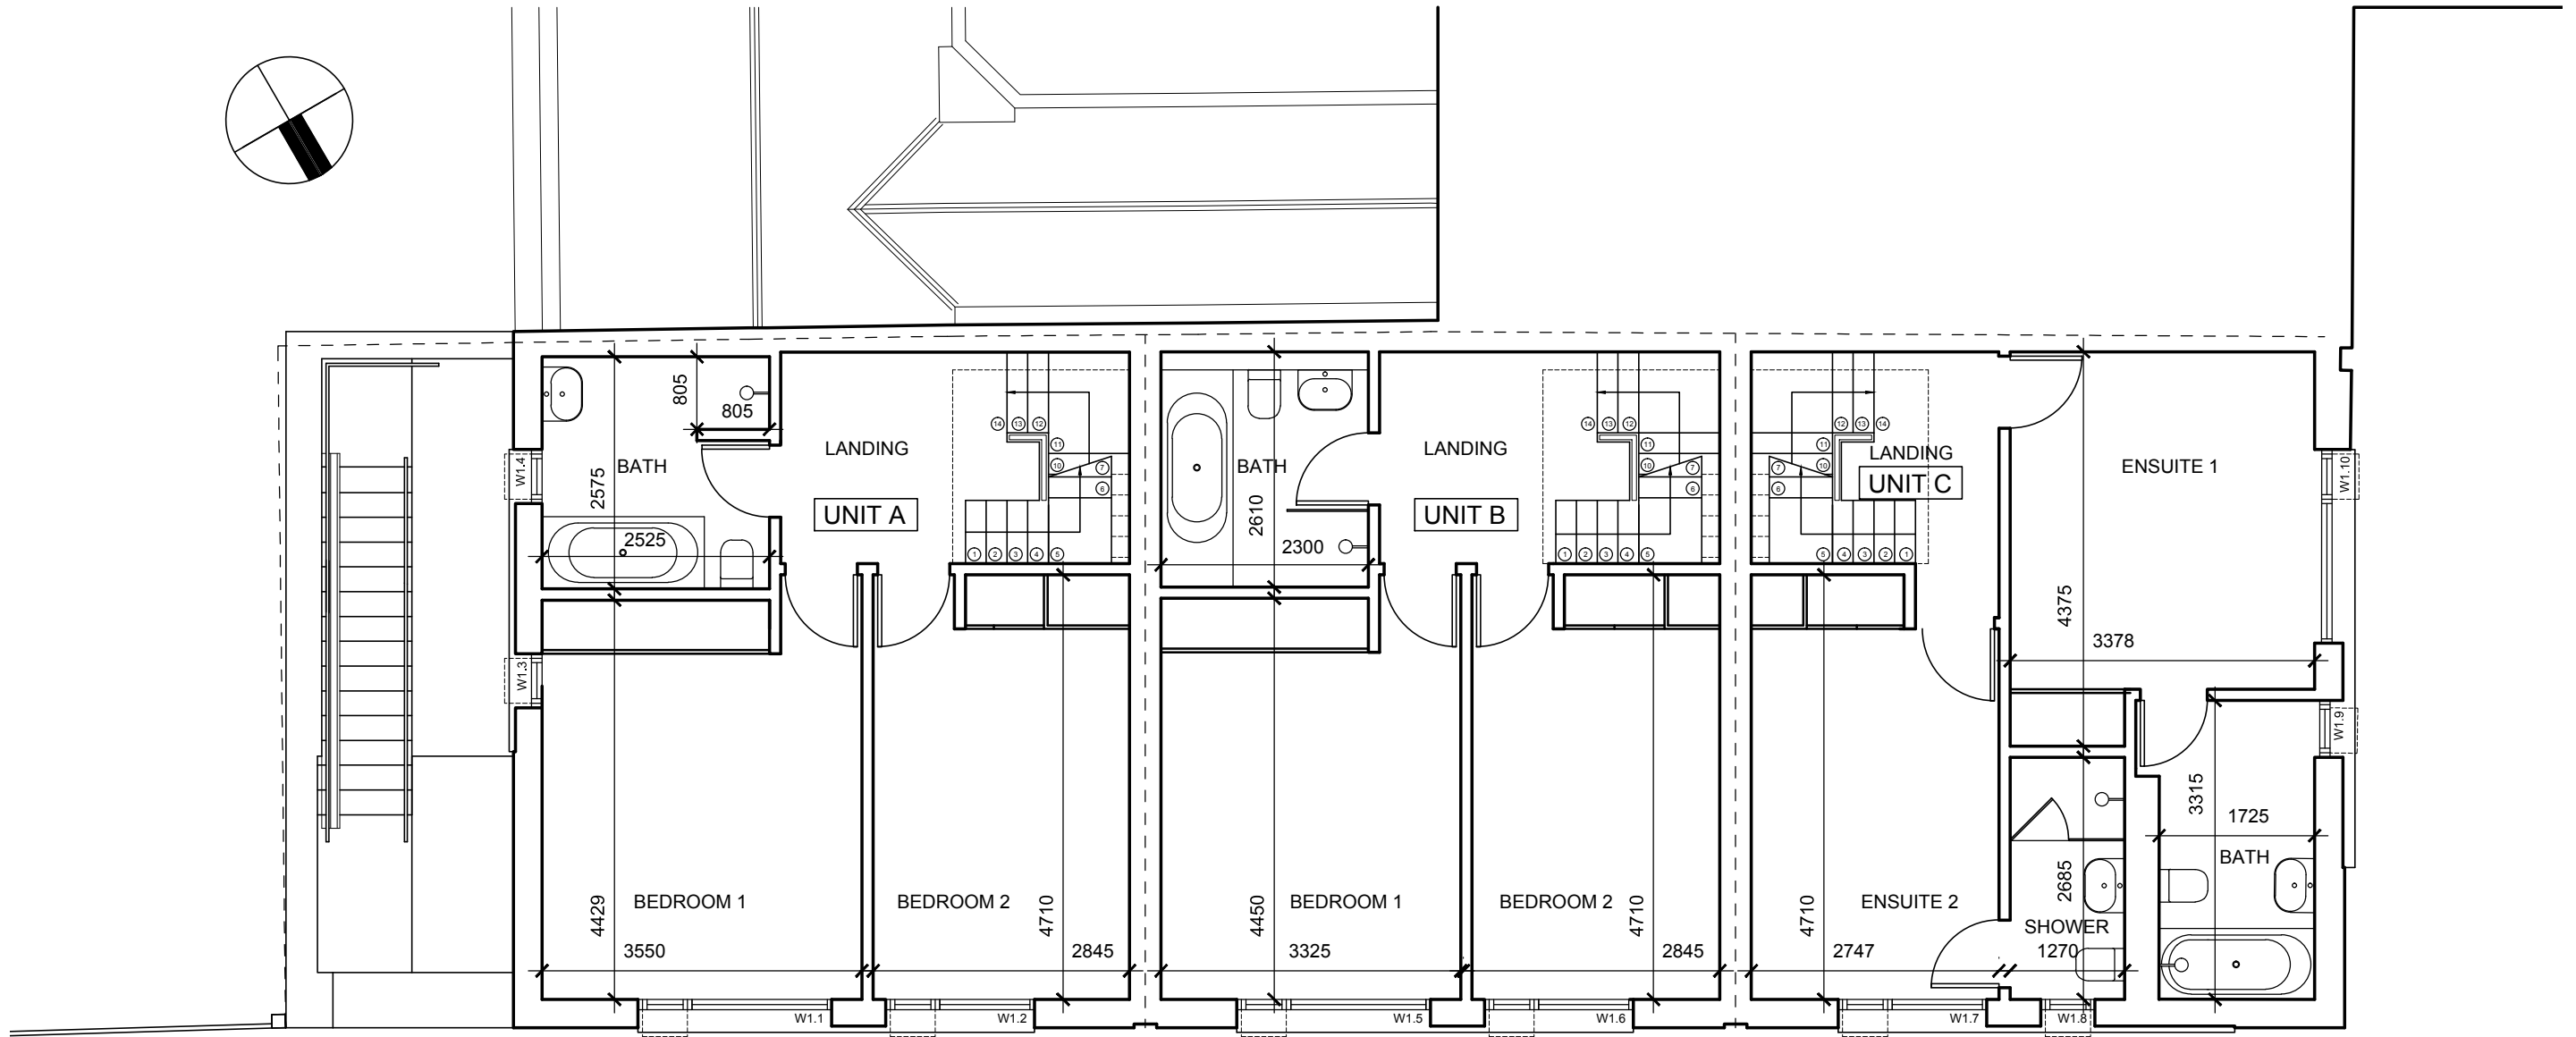

Notes

1. The architect retains copyright of this drawing. It should not be reproduced without prior written consent
2. Do not scale from this drawing, unless for PLANNING Project stage. Errors/omissions should be reported to the architect.
- 3.

NB: All dimensions shown are approximate as built for information only.

DETAILED DESIGN

Date of issue \ Project stage

17.07.17

Revisions

A General amendments

B 17.07.017 As built dimensions

Job title

3 Richborne Terrace, SW8 1AS
Lambeth

Drawing title


First floor plan
Setting out

David Money Architects

21 Claylands Place London SW8 1NL
T/F: 020 7587 3584 E: studio@davidmoney.com


Job number Scale@A3 Drawing number

DM242 1:75 3.12.03 B

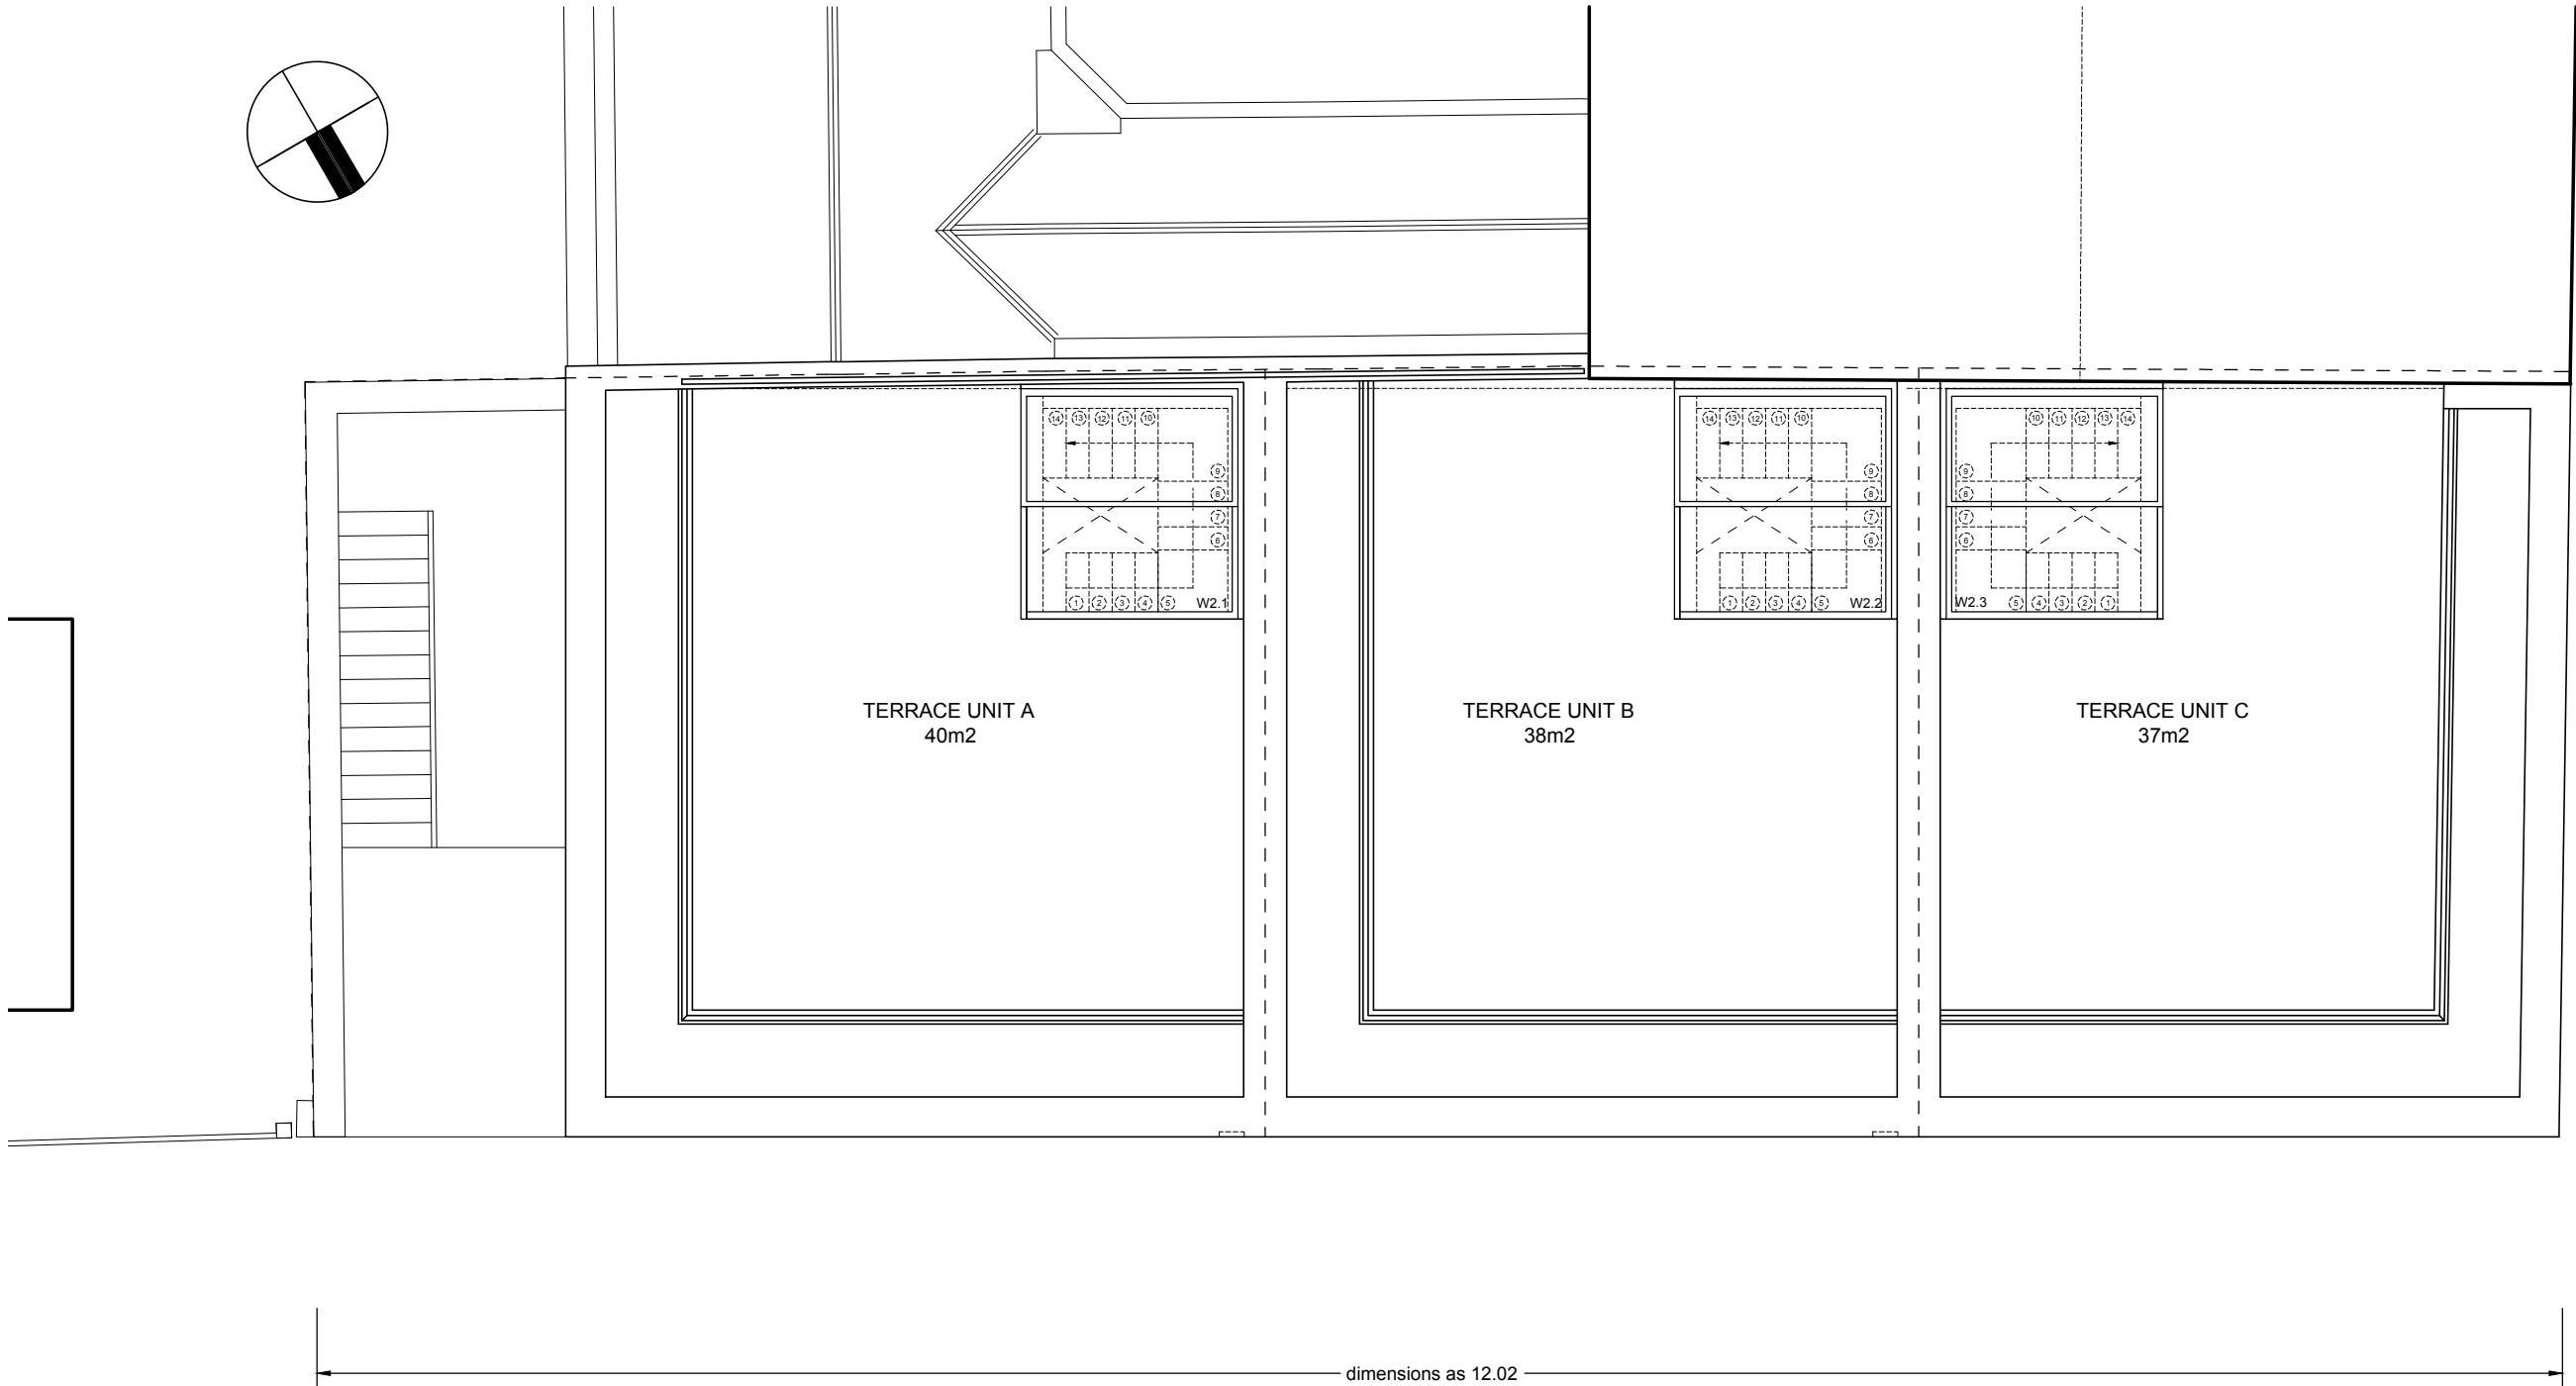

Notes

1. The architect retains copyright of this drawing. It should not be reproduced without prior written consent
2. Do not scale from this drawing, unless for PLANNING Project stage. Errors/omissions should be reported to the architect.
- 3.

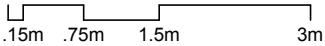

NB: All dimensions shown are approximate as built for information only.

DETAILED DESIGN

Date of issue \ Project stage

17.07.17

Revisions

A General amendments

B 17.07.17 As built dimensions

David Money Architects

21 Claylands Place London SW8 1NL
T/F: 020 7587 3584 E: studio@davidmoney.com

Job title

3 Richborne Terrace, SW8 1AS
Lambeth

Drawing title

Roof floor plan
Setting out

Job number

DM242

Scale@A3

1:75

Drawing number

3.12.04 B